BOSTON POST ROAD
MILFORD, CONN.

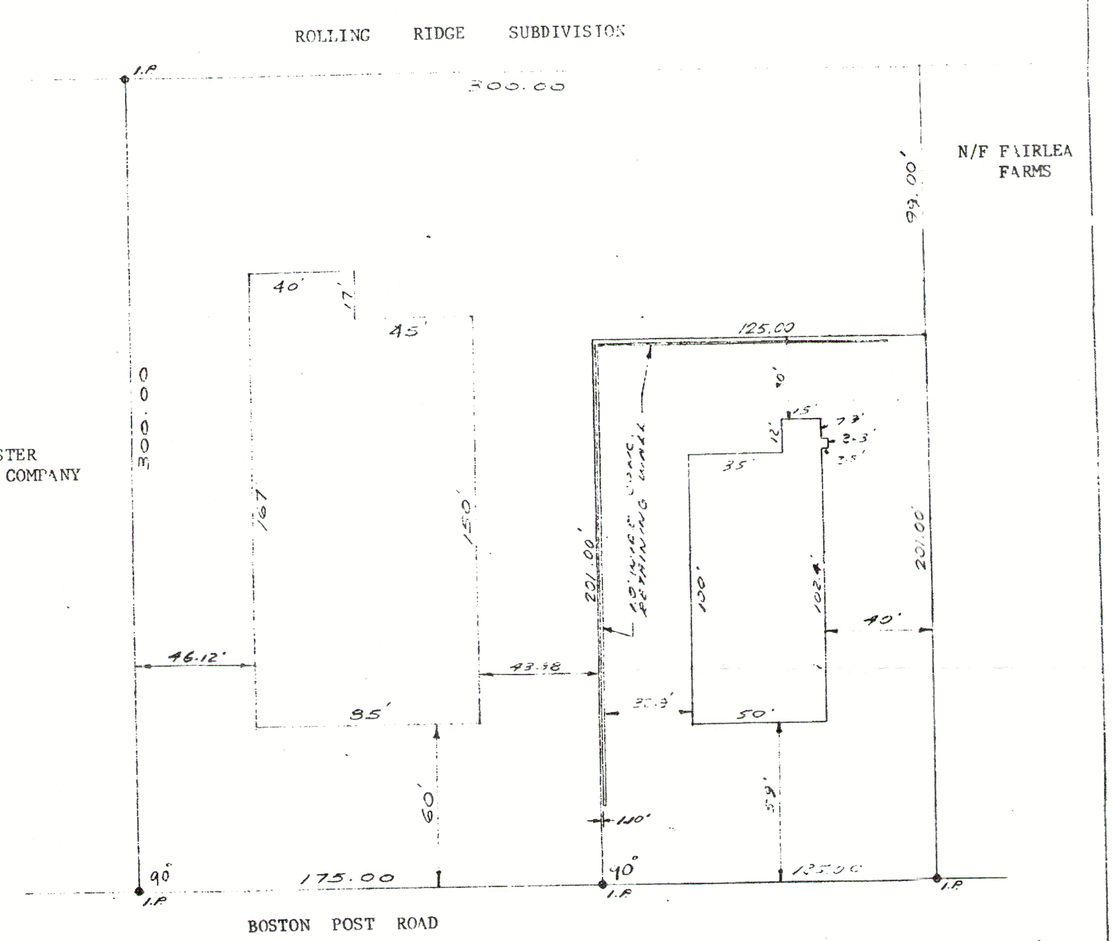


MAP # 811

Filed April 12-1973
at n m M In the office
of the Town Clerk of Orange, Conn.
By Marjorie B. Wahnquist
Town Clerk

PLOT PLAN
PROPERTY OF
T & M BUILDING COMPANY, INC.
507 BOSTON POST ROAD
~~ORANGE~~ ~~MILFORD~~, CONN.

STATE OF CONNECTICUT
MYRON FEINSTEIN
No. 5647
REGISTERED
LAND SURVEYOR

I HEREBY CERTIFY THIS PLAN TO BE SUBSTANTIALLY CORRECT;

MYRON FEINSTEIN ASSOCIATES
LAND SURVEYING & LAND PLANNING
ENGINEERING
WEST HARTFORD CONNECTICUT

| SCALE | DATE | REVISED | COMM. NO. |
|---|---|---|---|
| 1"=40' | 1-21-69 | 12-26-72<br>2-1-73<br>3-20-73<br>4-11-73 | 693 |